

TABLE OF CONTENTS

DEER CREEK MAPS AND DRAWINGS


Volume 6

Operation Plan

3-18	Deleted 4/30/04	
3-19	Deleted 4/30/04	
3-20	Main Access Road (Primary) Cross-Sections	CM-10881-DR

Reclamation

4-1	Deleted 4/30/04	
4-1A	Rilda Canyon Left Fork Proposed Final Reclamation Surface & Access Road	CM-10884-EM
4-2	Deleted 4/30/04	
4-3	Deleted 4/30/04	
4-4	Deleted 4/30/04	
4-4A	Rilda Canyon Access Road/Facilities Cross-Sections (2 Sheets) .	CM-10891-EM
4-5	Subsidence Monitoring Plan (3 Sheets)	CM-10400-DR
	East Mountain 1980 Primary Control Diagram	CM-10590-DR

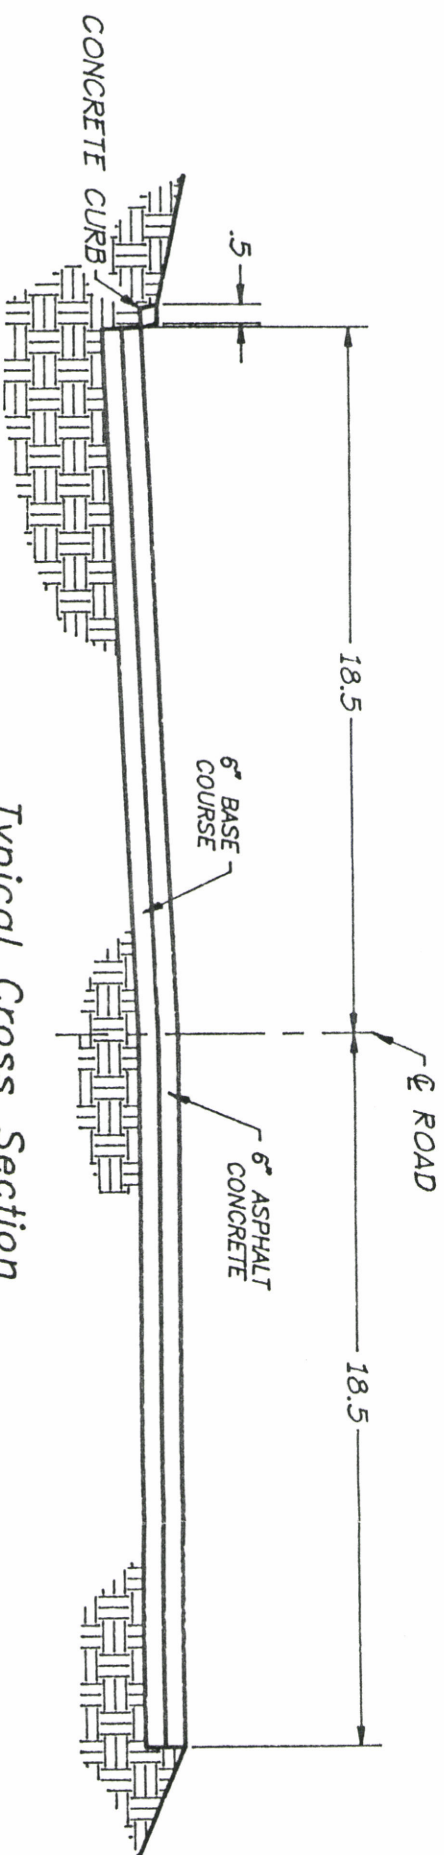

Typical Cross Section

Truck Loadout to Parking Lot

RECEIVED

JAN 21 1993

DIVISION OF
OIL, GAS & MINING

AMENDMENT TO

APPROVED Mining & Reclamation Plan
Approved, Division of Oil, Gas & Mining

JK DD-92A+92B Date 1/8/93




I CERTIFY THAT I AM A REGISTERED PROFESSIONAL ENGINEER IN THE STATE OF UTAH AND DO ALSO CERTIFY THAT THIS DRAWING IS ACCURATE IN DEPICTING THE AS-BUILT CONDITIONS OF THE ROAD CROSS SECTIONS TO THE BEST OF MY KNOWLEDGE AND BELIEF.

BLAKE WEBSTER NO. 7728


DATE

11/11/92

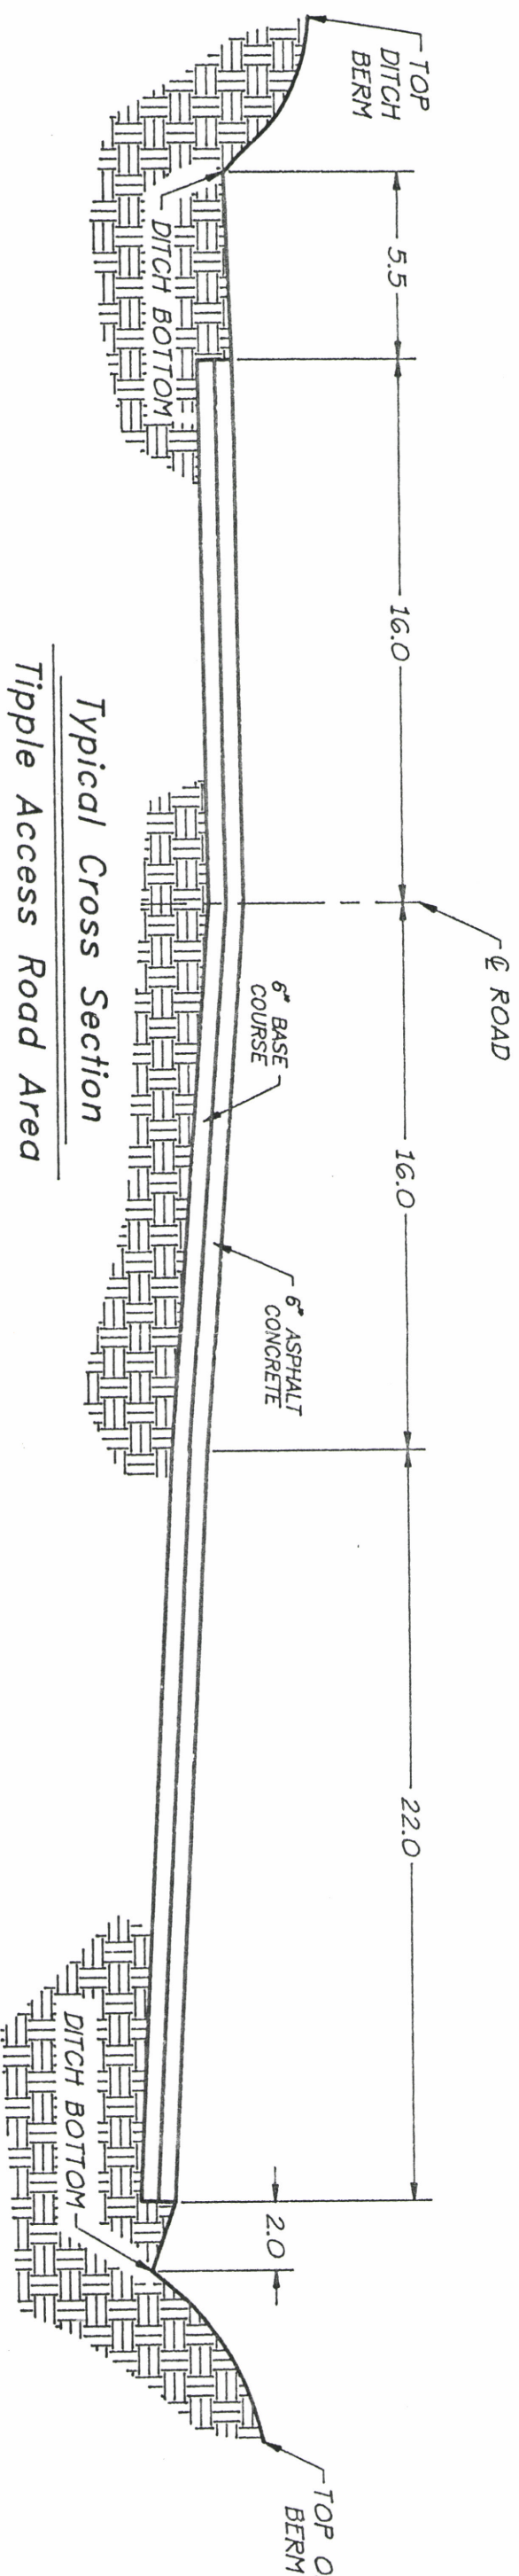

Typical Cross Section

Tipple Access Road Area

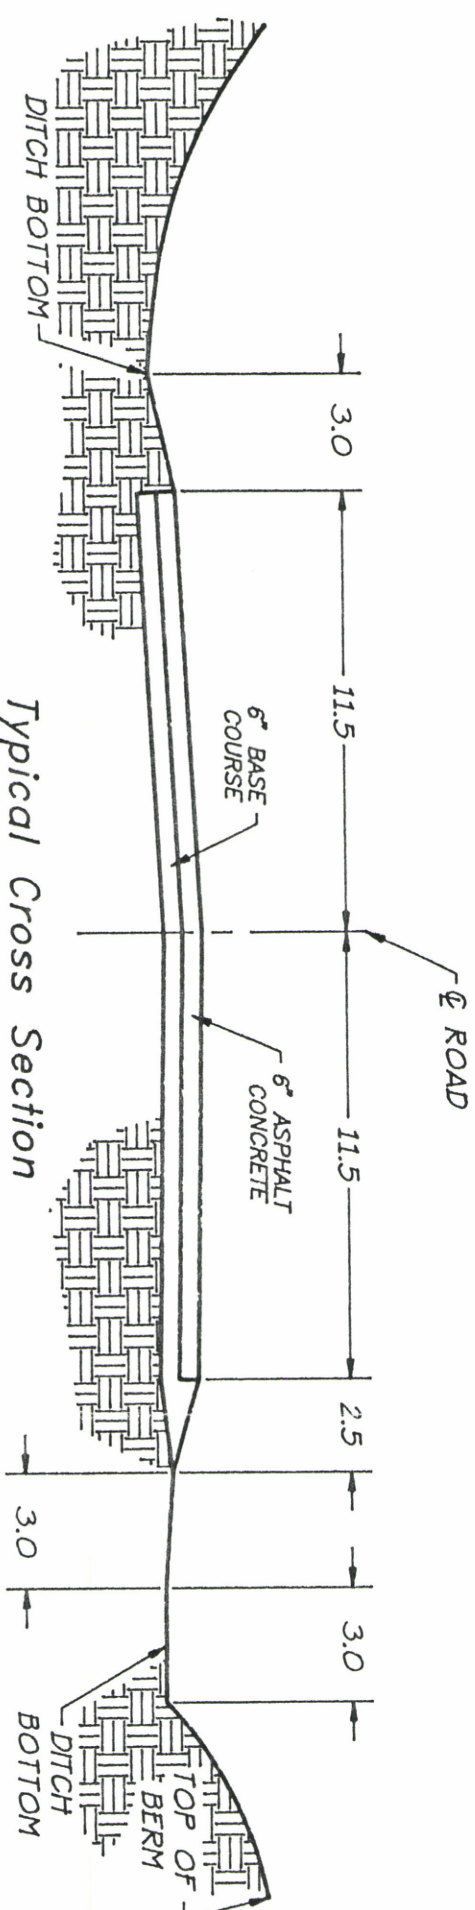

Typical Cross Section

Mine Security Gate to Tipple Access Road

CAD FILE NAME/DISK#: ACCESSRD

3-20

PACIFICORP

FUEL RESOURCES DEPARTMENT
201 SO. MAIN ONE UTAH CENTER SUITE 2000 SALT LAKE CITY, UTAH 84140-0020

DEER CREEK MINE
MAIN ACCESS ROAD (PRIMARY)
CROSS SECTIONS

DRAWN BY: K. LARSEN

CM-10881-DR

SCALE: 1"=5'

DRAWING #:

DATE: NOV. 10, 1992

SHEET 1 OF 1

REV.